


GENERAL NOTES

1. All dimensions and existing conditions shall be checked by the Contractor before proceeding with the work.
2. Refer to Window Schedule, Drawing A7.3A and A7.3B for extent of work at windows.
3. Refer to Door Schedule (bound in Project Manual) for extent of work at doors.
4. Refer to Schedule of Transparent (Non-Paint) Wood Finishes (bound in Project Manual) for extent of finishes at new and existing wood elements labeled "stain" and/or "refinish".
5. Refer to Metals Restoration Schedule (bound in Project Manual) for extent of finish work at all existing metals.
6. Refer to Masonry Restoration Drawings A6.12 through A6.18 for scope of masonry restoration.

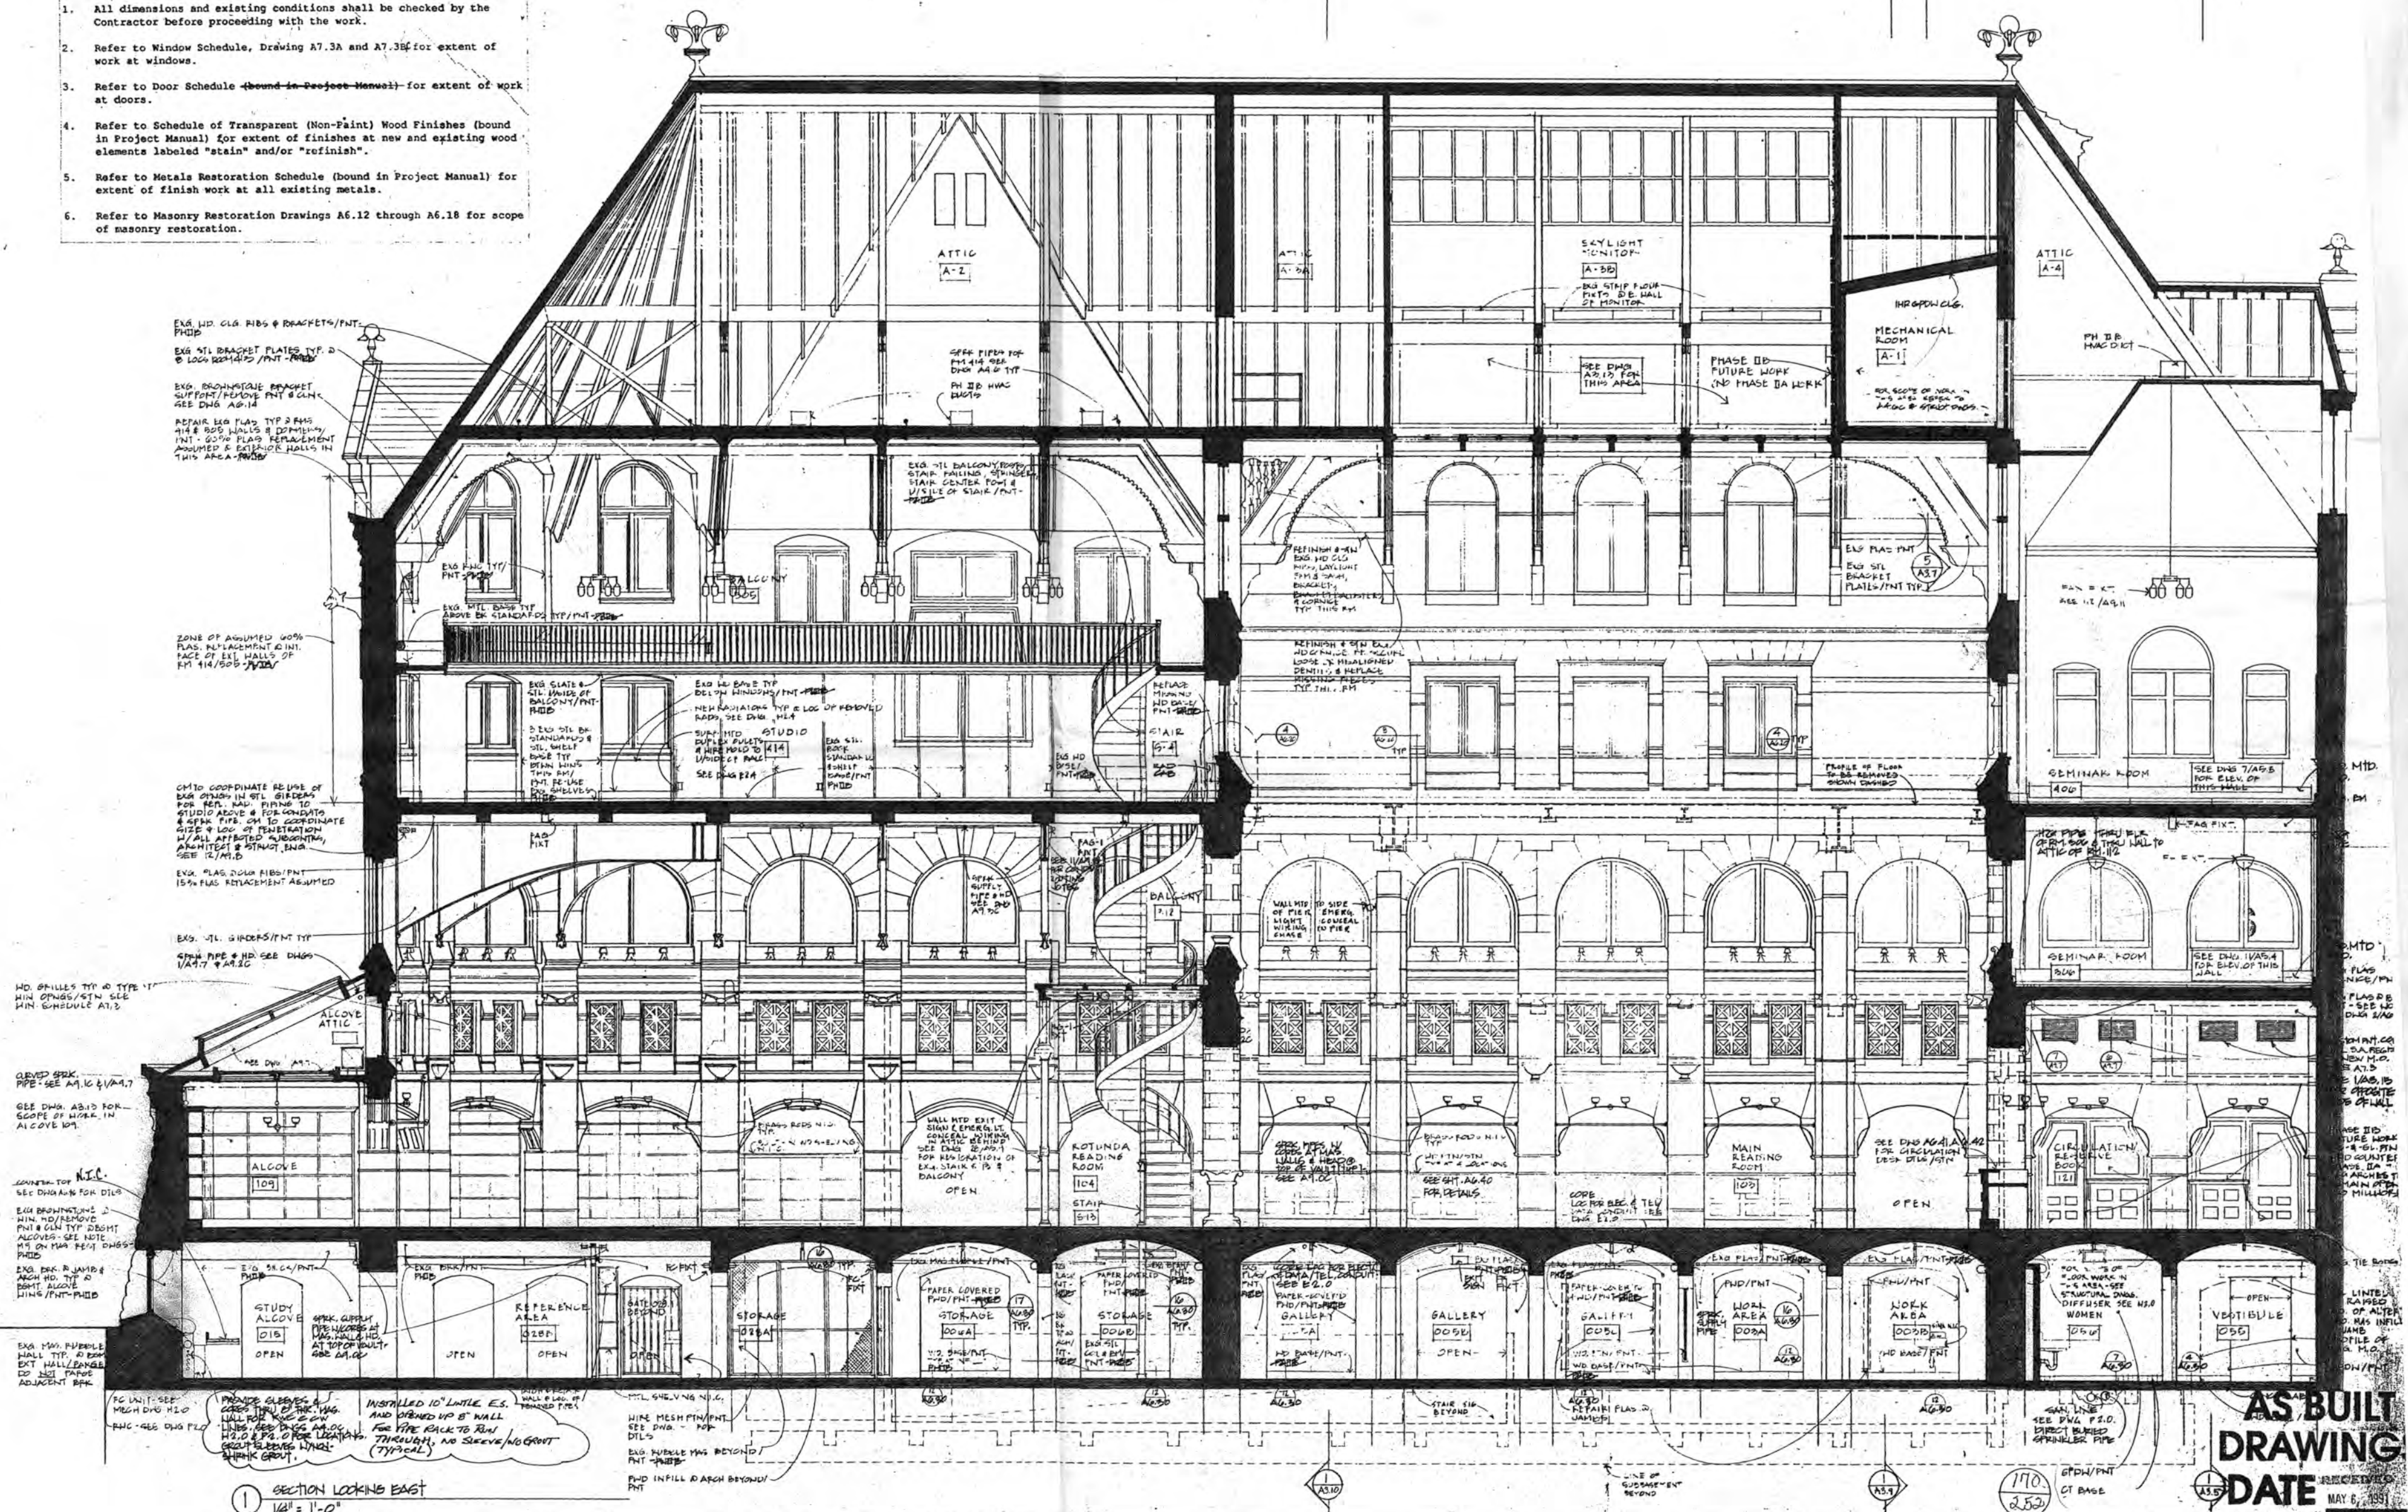

SECTION LOOKING EAST
1/4" = 1'-0"

Venturi, Rauch and Scott Brown, Architects
4236 Main Street, Philadelphia, PA 19127
215-487-0400
CLIO Group, Inc., Historical Consultants
3961 Baltimore Ave., Philadelphia, PA 19104
215-386-6276

Thomas & Newswanger Architects, Restoration
3961 Baltimore Ave. Philadelphia, PA 19104
215-386-0200
Kest and Hood Co., Structural Consultants
866 Suburban Station Bldg., Philadelphia, PA 19103
215-564-2777

Kervin Waxman Consulting Engineers, Mechanical Consultants
400 Greenwood Ave., Wyncote, PA 19095 215-572-1364
Irving Schwartz Associates, P.C., Electrical Consultants
400 Greenwood Ave., Wyncote, PA 19095 215-886-3160

PHASE 2 RENOVATIONS & RESTORATION
OF THE
FURNESS BUILDING
UNIVERSITY OF PENNSYLVANIA
PHILADELPHIA, PENNSYLVANIA

SECTION LOOKING EAST
Scale: 1/4" = 1'-0" 5-27-88
Drawn: 6-21-88
Checked: 8/14/88

**AS BUILT
DRAWING**
DATE MAY 6, 1991